


Sec-145 (Concourse Level)

■ - VENDING MACHINE (0 To 5 Sqm)
■ - Kiosk (5 To 10 Sqm)

All Dimension In METER
 TOTAL V.M. — 2
 TOTAL KIOSK — 1

Sec-145 (C10/124)

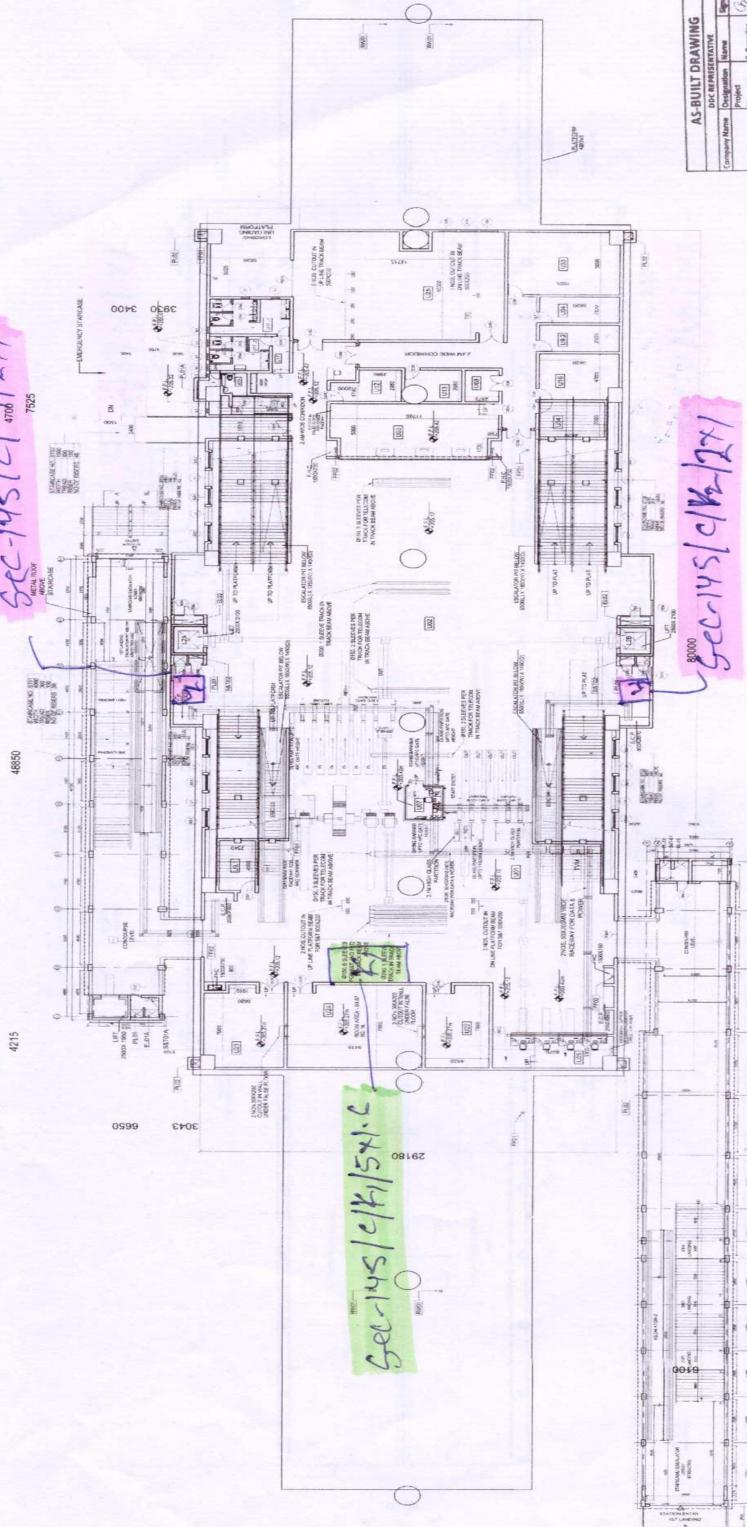

AS-BUILT DRAWING	
DOC REPRESENTATIVE	
Company Name	Designation
Project	Date
Signature	

Sec-145/C10/124

Sec-145/C10/1541.2